

STATE OF UTAH  
DEPARTMENT OF NATURAL RESOURCES  
DIVISION OF OIL, GAS AND MINING  
1594 West North Temple - Suite 1210  
Box 145801  
Salt Lake City, Utah 84114-5801  
Telephone: (801) 538-5291  
Fax: (801) 359-3940

11/3/08 *TL*

**LARGE MINING OPERATIONS 2007 PROGRESS REPORT**  
**January 1, 2007 to December 31, 2007**

The information required in this form are based on provisions of the Mined Land Reclamation Act, Title 40-8, and the rules as under the Utah Minerals Regulatory Program.

1. Mine Permit Number: M/270/006
2. Mine Name: Cricket Mountain Quarry
3. Name of Operator/Permittee: Graymont Western

Note: If Operator's address, company representative or phone number have changed, please provide a replacement page to the Notice of Intention.

4. Mine Location: Latitude: 38.94170, Longitude: -112.83870

5. Report the gross amount of ore mined and waste moved, as well as the arrangement, positioning, or distribution of the material:

Gross Ore Mined 2,189,057 Tons, or        yd<sup>3</sup>

Waste Material Moved 1,202,181 Tons, or        yd<sup>3</sup>

New Disturbance 31.7 Acres during 2007

Area Reclaimed 0 Acres during 2007

Total Disturbed Area 373.0 Acres\*

Was the ore shipped off site? If not, where is the ore located? Yes

Where is the waste located? On-site

\*Total life of mine disturbance to the end of 2007.

6. Briefly describe the reclamation work performed during the past year. A map showing reclaimed areas and dates is suggested. (Submit form MR-SITE for an application for full or partial bond/site release).

None

7. **Include an updated map depicting surface disturbance and reclamation performed during the year, prepared in accordance with Rule R647-4-105.**


**I hereby certify, under penalties of law, the information provided in this report is true and correct to the best of my knowledge and belief.**


Name (Typed or Print): Shawn Davis

Title of Operator: Mine Planning Engineer


Signature of Operator: \_\_\_\_\_

Date: January 30, 2008

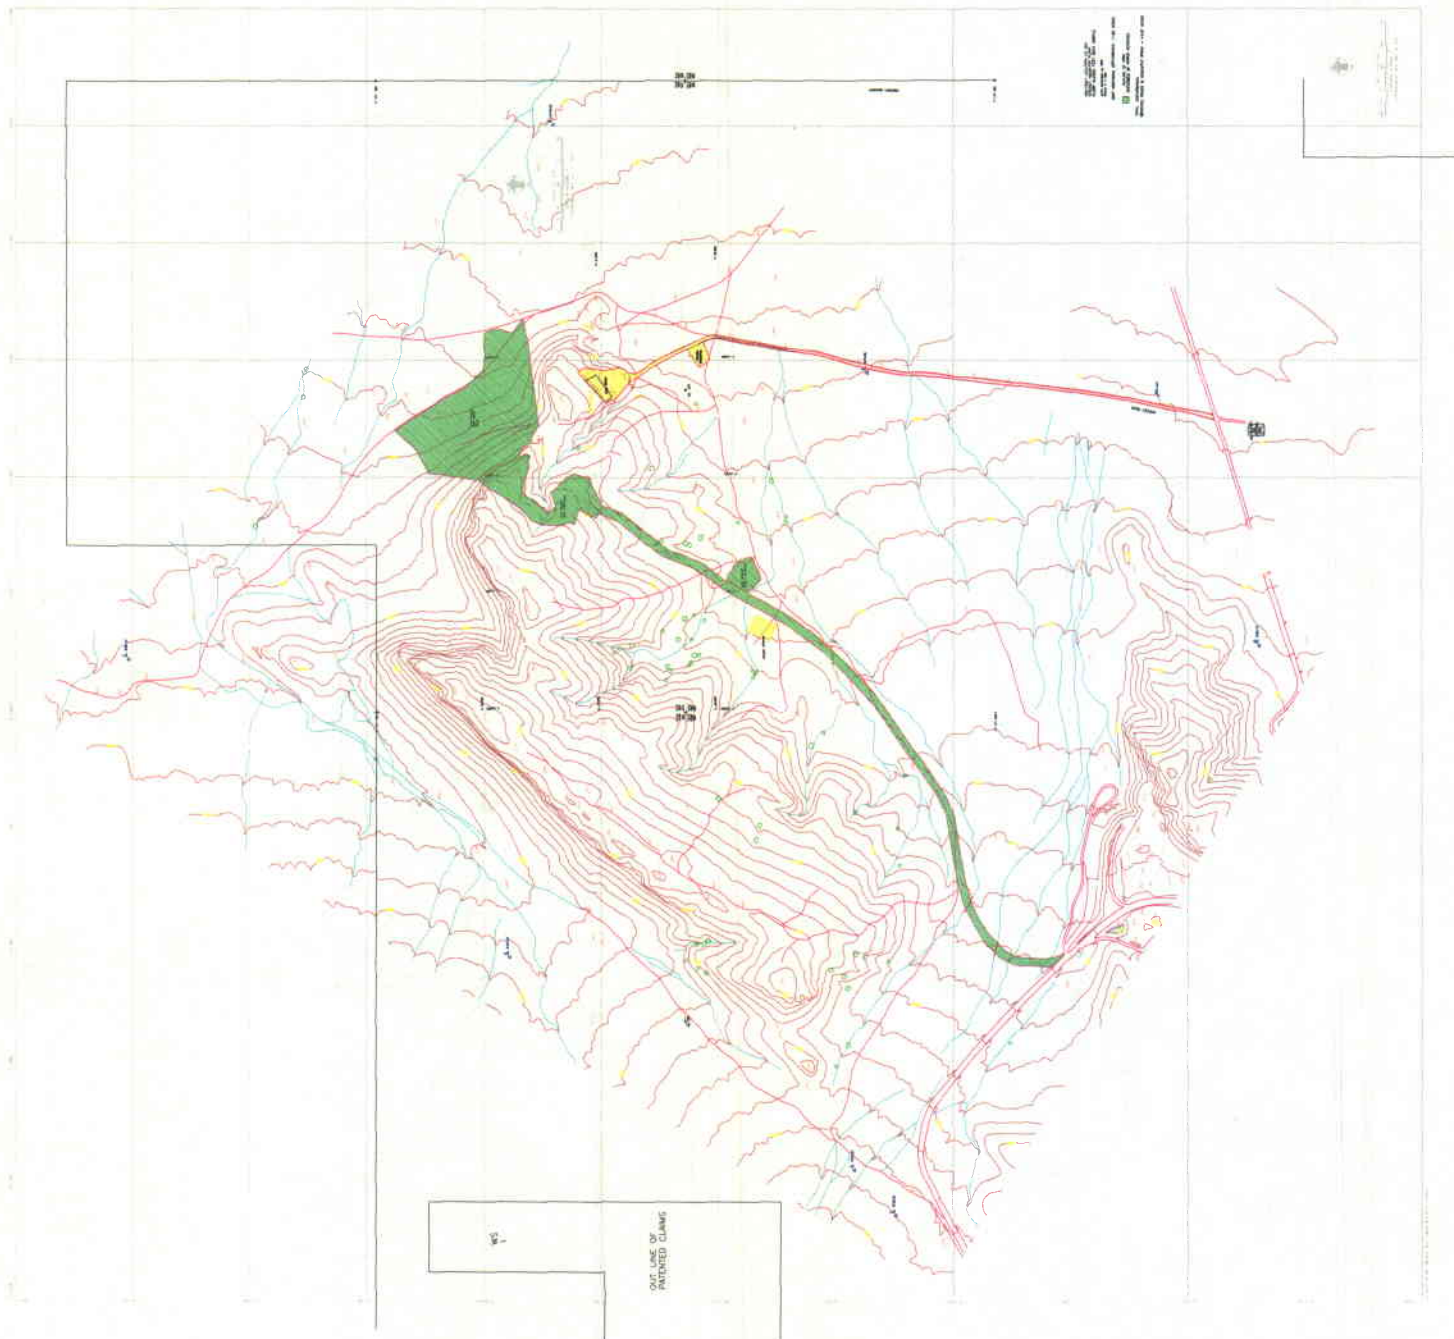


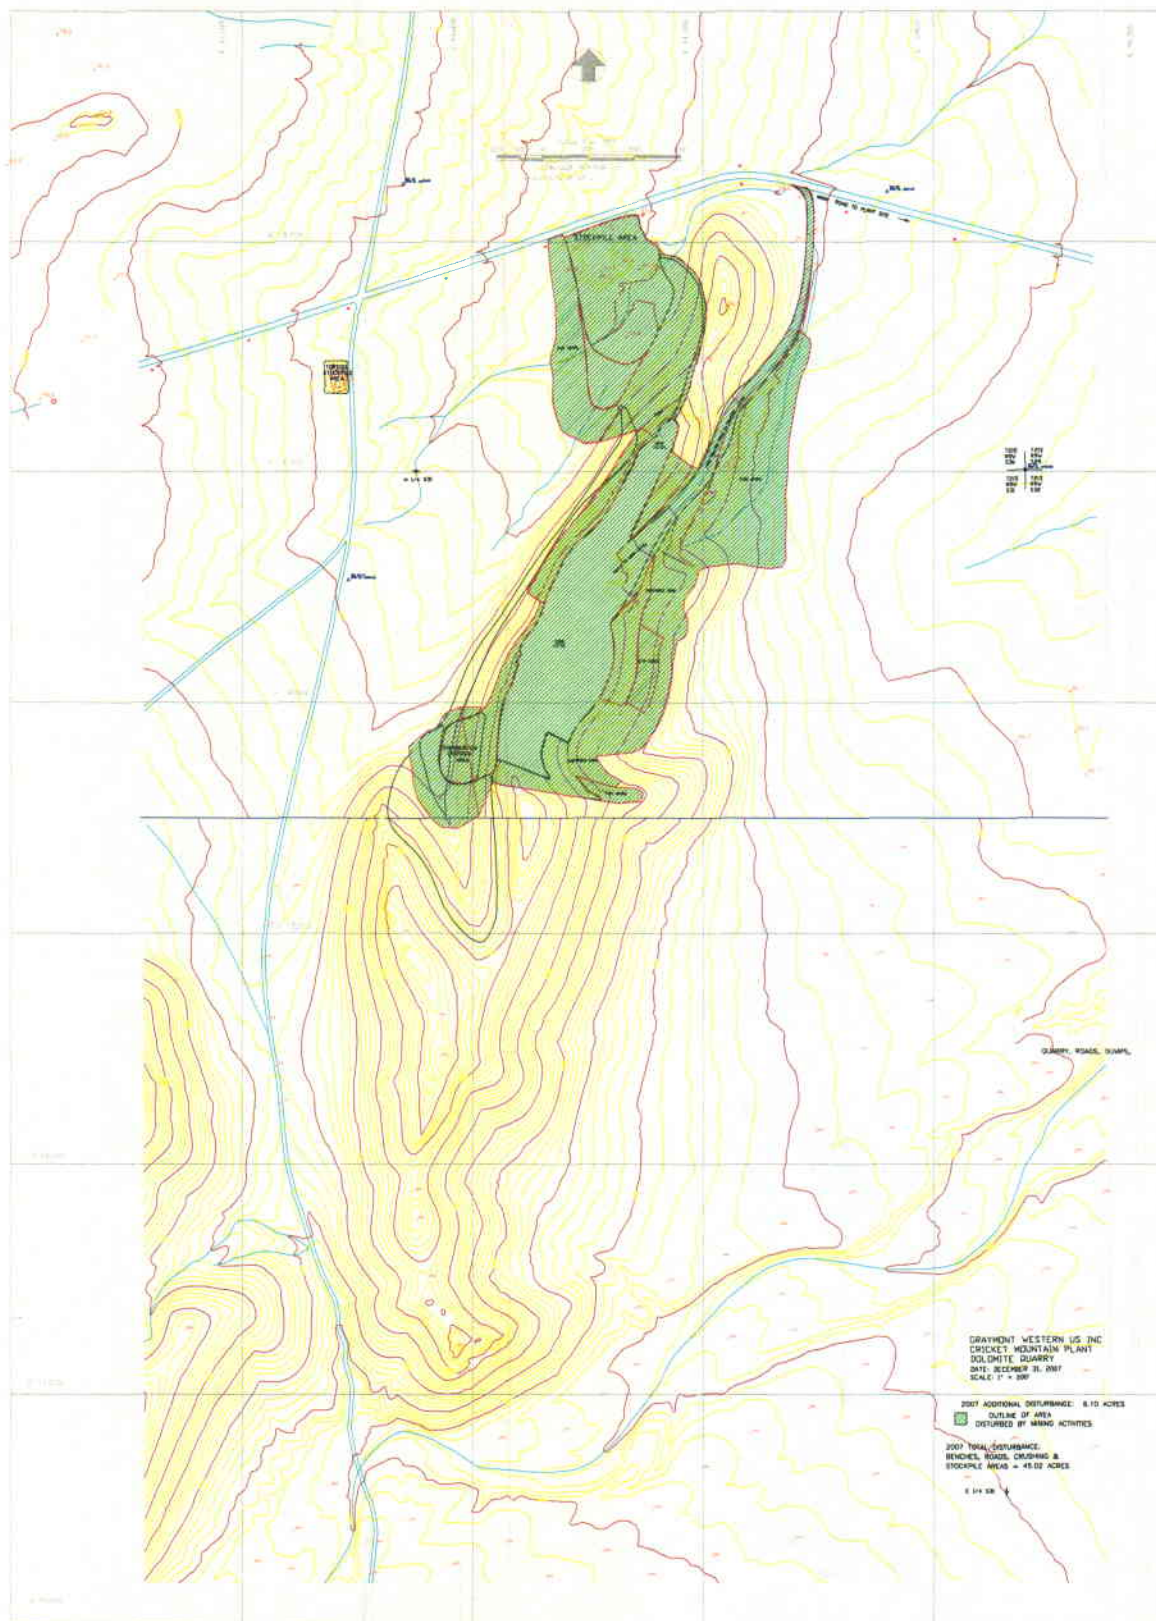



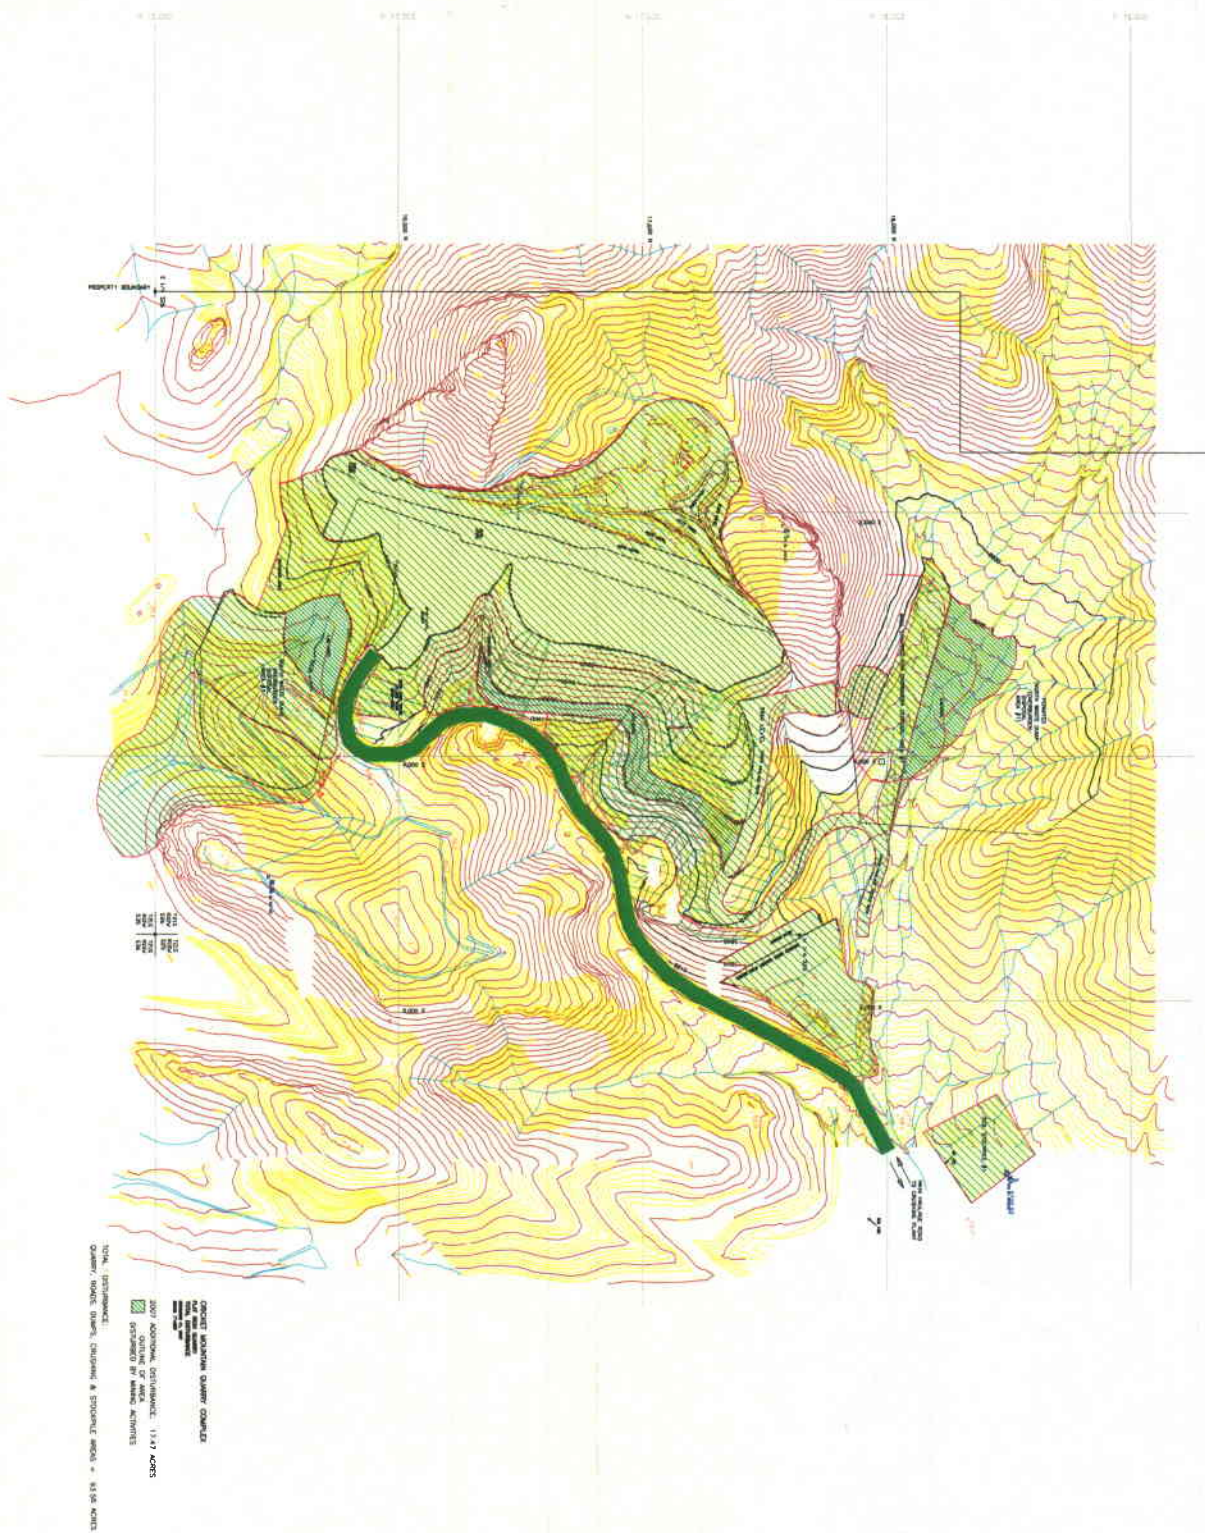



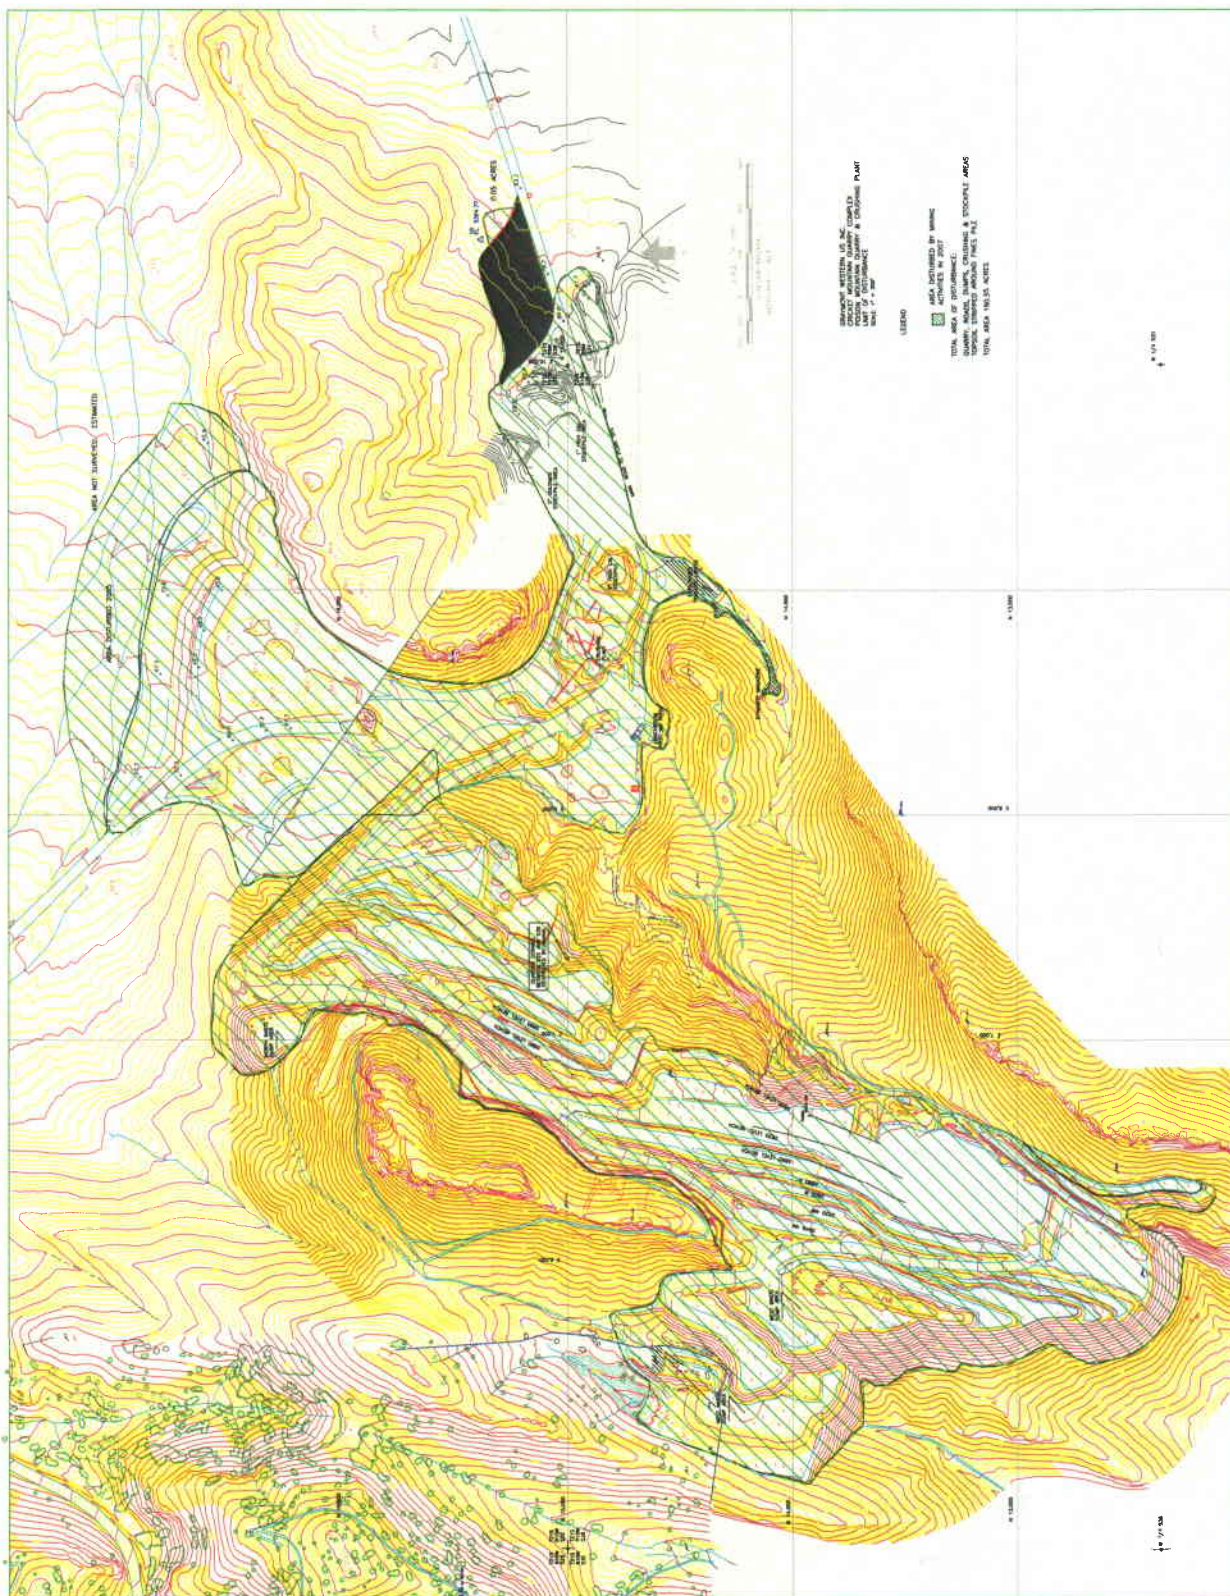

PROJECT: WATERSHED & LAND  
USE STUDY  
DATE: 10/1/2017  
SCALE: 1" = 200'

LEGEND

AREA IMPROVED BY  
ACTIVITIES IN 2017  
TOTAL AREA OF IMPROVEMENT:  
TOTAL AREA IMPROVED BY  
ACTIVITIES IN 2017  
TOTAL AREA IMPROVED BY  
ACTIVITIES IN 2017

1" = 200'

1" = 200'